

**LEGEND**


- STORMWATER DRAINAGE
- WATER RETICULATION
- SEWERAGE
- ELECTRICAL
- W/S WATER OVER SEWER
- W/D WATER OVER STORMWATER
- W/E WATER OVER ELECTRICAL
- S/D SEWER OVER STORMWATER
- D/S DRAINAGE OVER SEWER
- E/D ELECTRICAL OVER DRAINAGE
- E/S ELECTRICAL OVER SEWER
- D/W DRAINAGE OVER WATER
- D/E DRAINAGE OVER ELECTRICAL

**NOTES**

1. REFER DRAINAGE AND SEWER LONGITUDINAL SECTIONS FOR FURTHER DETAILS OF SERVICE CROSSINGS.

**WARNING**  
**BEWARE OF SERVICES**  
 The locations of all existing services are approximate only and their exact position should be proven on site. No guarantee is given that all existing services are shown.


**AS CONSTRUCTED INFORMATION**  
**CERTIFIED BY BRIERTY PTY LTD**

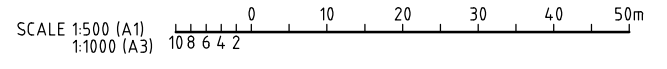

**AS CONSTRUCTED**

DATE: 8/05/2015 10:22:43 AM LOGIN NAME: LOCATION: C:\Users\jhaydn\AppData\Local\projectwise\darwin\_projects\dm\04\FSD\B05941\_200-ECC-DG-0039.dwg

REV	DATE	DRAWN	REVD	APPD	REVISION
1	30.04.15	GAC	RJB	LM	AS CONSTRUCTED
0	20.02.15	JAH	RJB	LM	ISSUED FOR CONSTRUCTION

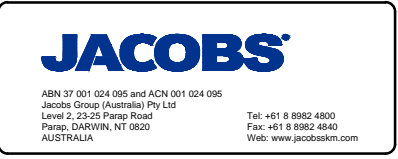

CLIENT TERRITORY LIFE			
PROJECT MITCHELL CREEK GREEN STAGE 2B			
DRAWN JAH	DRAWING CHECK RJB	REVIEWED L.MUIR	APPROVED D.CAMERON
DESIGNED RJB	DESIGN REVIEW LM	DATE 5/12/2014	DATE 5/12/2014

TITLE MASTER SERVICES PLAN			
SCALE AS SHOWN	DRAWING No DB05941.200-ECC-DG-0039	POWER WATER CORP. No B14-12064	REV 1