



LEGEND

- STORMWATER DRAINAGE
- WATER RETICULATION
- SEWERAGE
- ELECTRICAL
- W/S WATER OVER SEWER
- W/D WATER OVER DRAINAGE
- W/E WATER OVER ELECTRICAL
- S/D SEWER OVER DRAINAGE
- D/S DRAINAGE OVER SEWER
- E/D ELECTRICAL OVER DRAINAGE
- E/S ELECTRICAL OVER SEWER
- D/W DRAINAGE OVER WATER
- D/E DRAINAGE OVER ELECTRICAL
- PROPOSED DRIVEWAY


NOTES

1. REFER DRAINAGE AND SEWER LONGITUDINAL SECTIONS FOR FURTHER DETAILS OF SERVICE CROSSINGS.


**AS CONSTRUCTED INFORMATION
CERTIFIED BY BRIERTY PTY LTD**

**WARNING
BEWARE OF SERVICES**
The locations of all existing services are approximate only and their exact position should be proven on site. No guarantee is given that all existing services are shown.

PERMISSION TO USE FOR CONSTRUCTION PURPOSES ONLY
SIGNED: D.Buentipo DATE: 31/03/2015
ON BEHALF OF WATER SERVICES FOR THE INCORPORATION INTO POWER AND WATER CORPORATION'S NETWORK.
This permission to use this Approved Design is given on the basis that the developer and/or consultant is not absolved from full responsibility for the correctness and accuracy of the design and/or documents so associated.
This drawing is valid for 2 years from the date of signing.

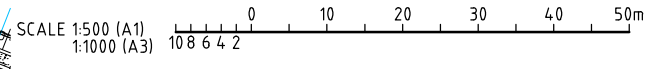

AS CONSTRUCTED

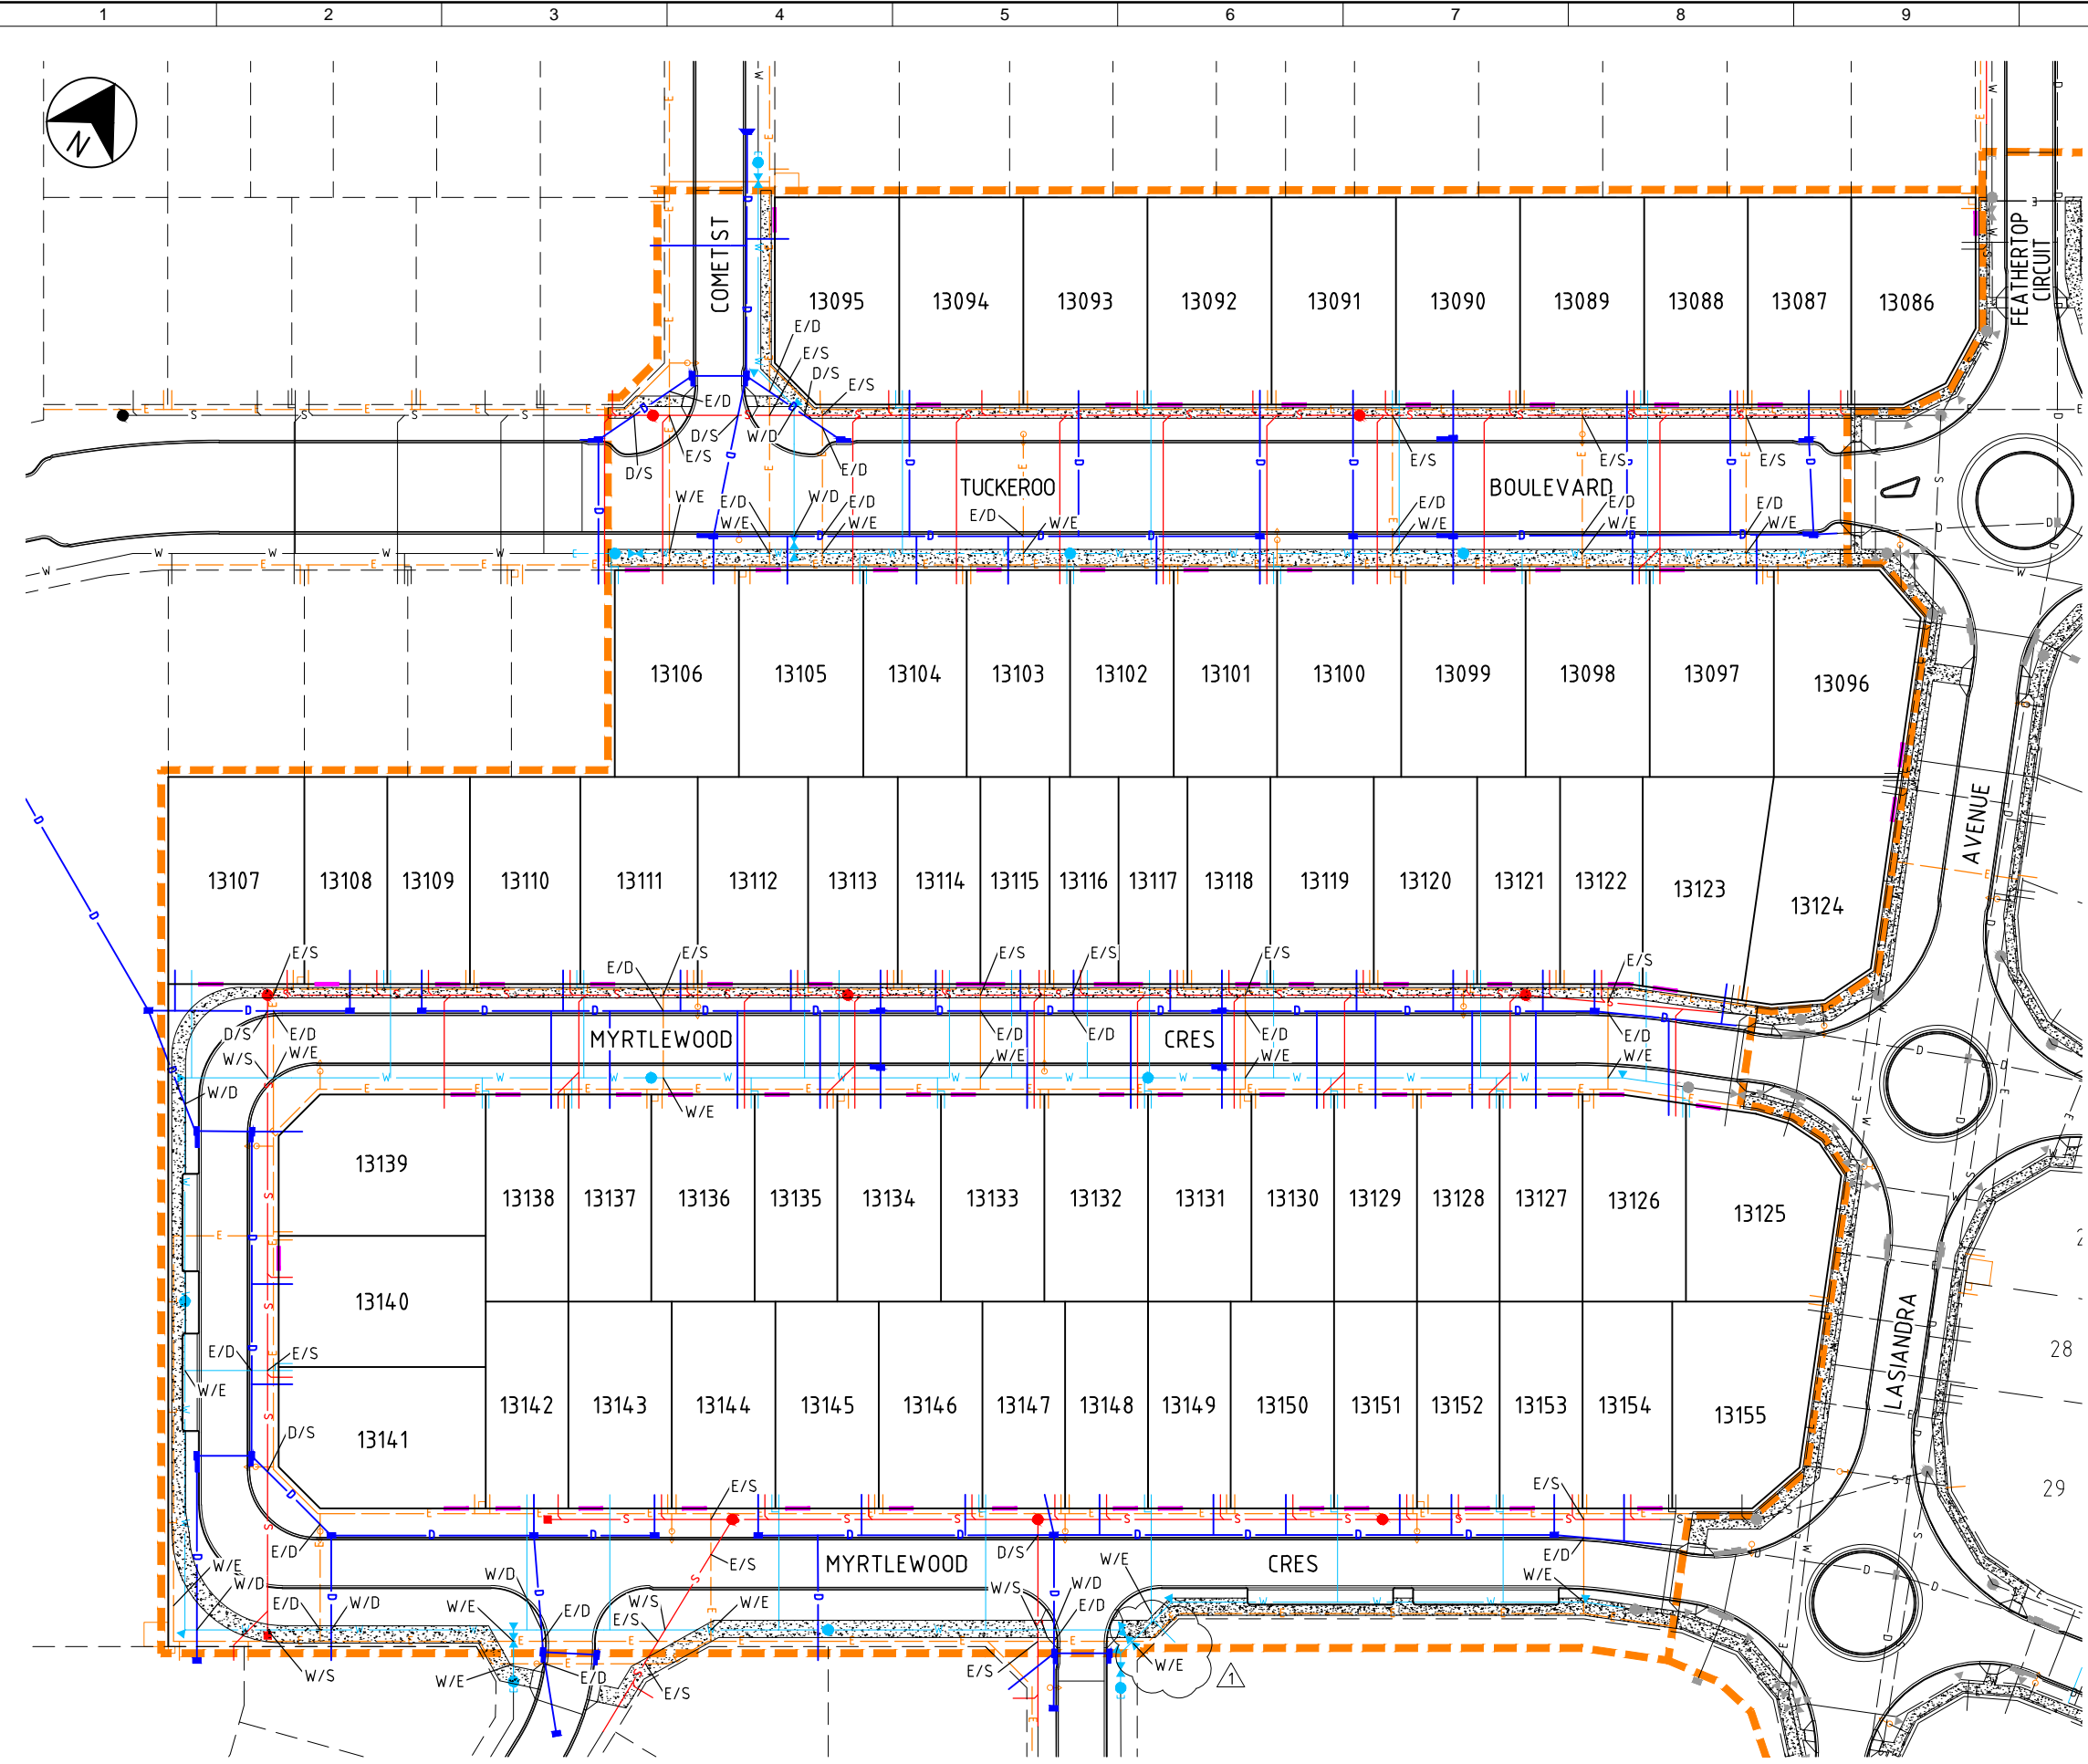

DATE: 13/11/2015 11:21 PM LOGIN NAME: LOCATION: C:\user\rbourby\appdata\local\project\issued\dwg\projects\ms0475\0605941_300-ECC-DG-0038.dwg

1	11.09.15	TAB	RJB	TN	AS CONSTRUCTED
0	14.04.15	JAH	RJB	LM	ISSUED FOR CONSTRUCTION
REV	DATE	DRAWN	REV'D	APP'D	REVISION



CLIENT: TERRITORY LIFE			
PROJECT: MITCHELL CREEK GREEN STAGE 2C			
DRAWN: JAH	DRAWING CHECK: RJB	REVIEWED: L.MUIR	APPROVED: D.CAMERON
DESIGNED: RJB	DESIGN REVIEW: LM	DATE: 19.12.14	DATE: 19.12.14

TITLE: MASTER SERVICES PLAN			
SCALE: AS SHOWN	DRAWING No: DB05941.300-ECC-DG-0038	POWER WATER CORP. No: B14-13518	REV: 1