

KEY PLAN


LEGEND

- AREAS OF FILL
- FINISHED SURFACE LEVEL
- NATURAL SURFACE LEVEL
- FALL OF LOTS
- DESIGN SURFACE CONTOURS (0.2m INTERVAL)
- EXISTING SURFACE CONTOURS (0.2m INTERVAL)
- EXISTING STORMWATER DRAINAGE
- EXISTING ELECTRICAL
- EXISTING SEWERAGE
- EXISTING WATER
- PROPOSED RETAINING WALL

AS CONSTRUCTED INFORMATION
CERTIFIED BY BRIERTY PTY LTD

WARNING
BEWARE OF SERVICES
The locations of all existing services are approximate only and their exact position should be proven on site. No guarantee is given that all existing services are shown.

PERMISSION TO USE FOR CONSTRUCTION PURPOSES ROADWORKS AND STORMWATER DRAINAGE.
SIGNED: I Dimec DATE: 25/04/2015
DIRECTOR OF TECHNICAL SERVICES
CITY OF PALMERSTON
This permission is given on the basis that the Developer and/or Consultant is not absolved from full responsibility for the correctness and accuracy of the design and/or documents associated. This permission is valid for a period of two years from the date of signed approval.

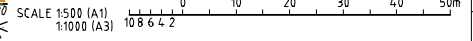

CONSTRUCTION ISSUE

REV	DATE	DRAWN	REV'D	APPR	REVISION
1	27.10.15	GAC	TN	DC	AS CONSTRUCTED - STAGE 2D
0	09.08.15	GAC	LM	TN	ISSUED FOR CONSTRUCTION



CLIENT	TERRITORY LIFE	DESIGNED	RUB	APPROVED	D.CAMERON
PROJECT	MITCHELL CREEK GREEN STAGES 2D & 2E	DESIGNED	RUB	DATE	07.04.15
DRAWN	GAC	DESIGNED	LM	DATE	07.04.15

TITLE	BULK EARTHWORKS PLAN SHEET 1 OF 2	SCALE	1:500 (A1)	DRAWING NO.	DB05941.400-ECC-DG-0009	REV	1
-------	-----------------------------------	-------	------------	-------------	-------------------------	-----	---

DATE: 28/10/2015 4:52:27 PM LOGIN NAME: C:\Users\Comer\Documents\Projects\mitchell_creek_green\stages_2d_and_2e\DWG\A1-ECC-DG-0009.rvt